

ADDENDUM NUMBER ONE

WALK-IN COOLER AND FREEZER REPLACEMENT

SANTEE SCHOOL DISTRICT

CHILD NUTRITION SERVICES

BID #1920-090-001

DATE: January 21, 2020

General - All project documents including contract documents, drawings, and specifications, shall remain unchanged with the exception of those elements added, revised, deleted, or clarified by this addendum. **Acknowledge receipt of Addendum Number One in the appropriate place provided on the Bid Form**

ITEM NO. 1 ADDENDUM ONE	Replace Special Conditions: Q. Scope of Work, Item #5
----------------------------	---

A) **Replace Special Conditions: Q. Scope of Work, Item #5:**

5. Supply and install new 5.5 hp 208/230v 3ph mechanical system for walk-in **freezer**

ITEM NO. 2 ADDENDUM ONE	Add Special Conditions: Q. Scope of Work, Item #8
----------------------------	---

A) **8.** Supply and install new 1 hp 208/230v 3ph mechanical system for walk-in cooler.

ITEM NO. 3 ADDENDUM ONE	Replace Plans Sheet 1 of 5 with attached Revised Sheet No. 1 of 5
----------------------------	---

A) **Replace Plans Sheet 1 of 5 with attached Revised Sheet No. 1 of 5, which states “No Floor. Please add seismic anchoring for cooler and freezer”.**

END OF ADDENDUM ONE

SANTEE SCHOOL DISTRICT

WALK-IN COOLER AND FREEZER REPLACEMENT

CHILD NUTRITION SERVICES

BID #1920-090-001

<p>ADDENDUM NUMBER ONE</p> <p>WALK-IN COOLER AND FREEZER REPLACEMENT</p> <p>CHILD NUTRITION SERVICES</p> <p>BID #1920-090-001</p>	<p>Page 1 of 1</p>
--	--------------------



Revisions:

No.	DATE & BY
1	—/—/—
2	—/—/—
3	—/—/—
4	—/—/—
5	—/—/—
6	—/—/—
7	—/—/—
8	—/—/—

APPROVED AS DRAWN
 APPROVED AS NOTED
 RESUBMIT

SIGNED: _____
 DATE: _____

CONFIDENTIAL


THE DRAWINGS, TECHNICAL DATA, AND ALL OTHER INFORMATION SET FORTH IN THIS DOCUMENT COMPRISE TRADE SECRETS AND CONFIDENTIAL INFORMATION THAT IS THE EXCLUSIVE PROPERTY OF ARCTIC INDUSTRIES, LLC.

USE OF SUCH INFORMATION IS LIMITED TO THE PURPOSE FOR WHICH IT WAS PROVIDED AND NO RECIPIENT IS PERMITTED TO USE, COPY, OR DISCLOSE SUCH INFORMATION EXCEPT AS EXPRESSLY AUTHORIZED BY ARCTIC INDUSTRIES, LLC.

DRAWING APPROVAL

APPROVED
 APPROVED AS NOTED
 NOT APPROVED-RESUBMIT

DATE: _____ SIGN: _____

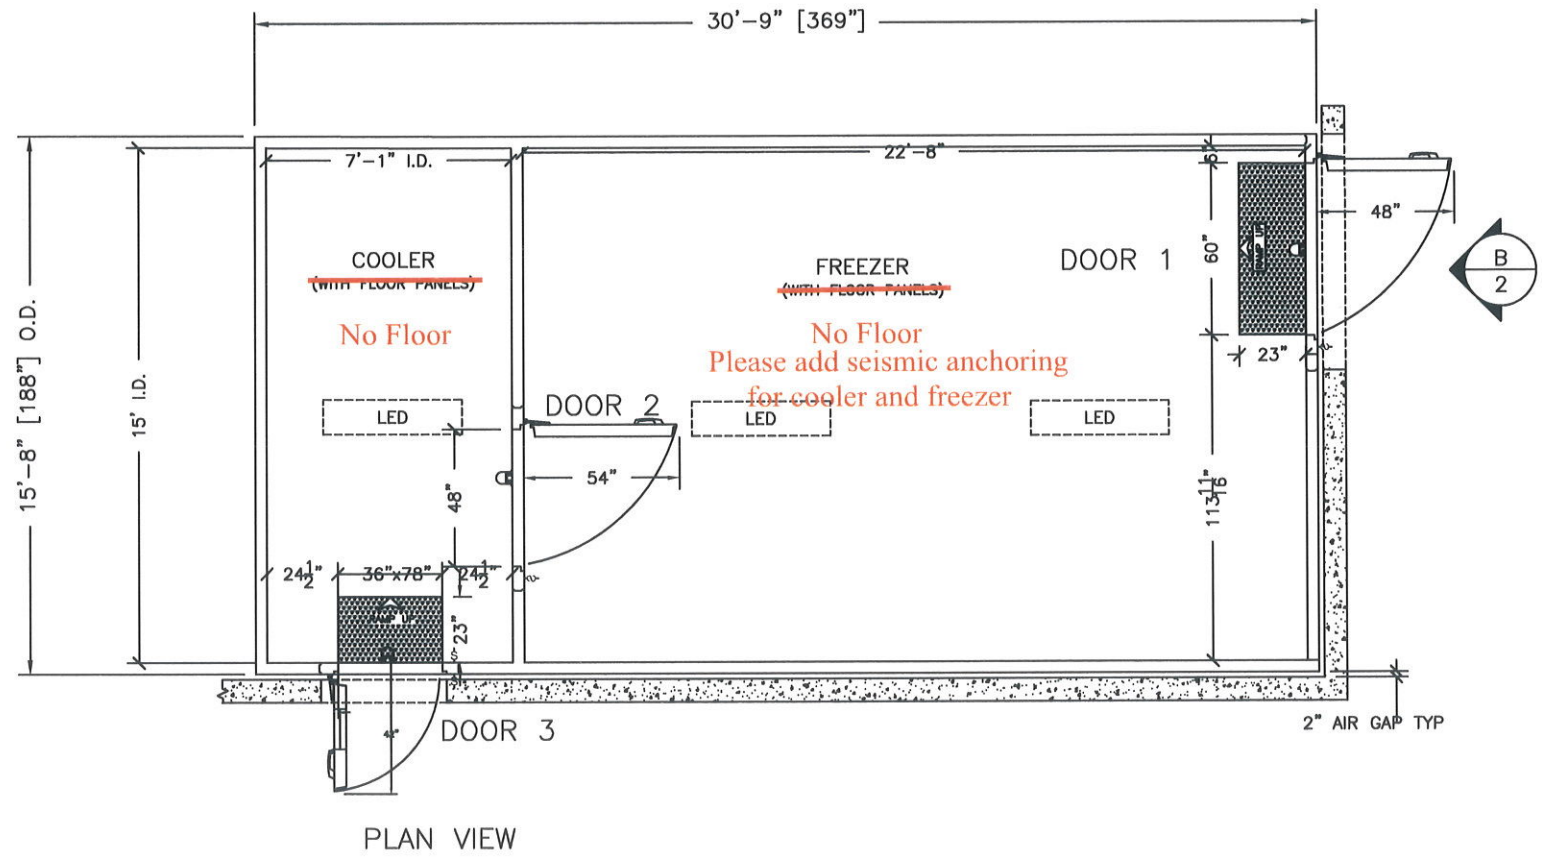

Customer Name: XCE COOLERS		
Project Name: SANTEEV SCHOOL DISTRICT, LOS ANGELES, CA		P.O#:
Drawn By: EPM	Checked By: MG	DRW No: Q
Scale: 3/16" = 1'	Created: 10/2/19	Sheet No: 1 OF 5